

Date: Thursday, 6/21/2007 2:27:01 PM
User: Kim Johnston

Process Sheet

Customer : CU-DAR001 Dart Helicopters Services

Drawing Name : TUBE ASSEMBLY

Job Number : 33030

Estimate Number : 10921

P.O. Number : N/A

This Issue : 6/21/2007

S.O. No. : N/A

Prsht Rev. : NC

First Issue : MA

Type : SMALL /MED FAB

Previous Run : 27297

Part Number : D2003041

Drawing Number : ~~UNDER REVIEW~~

Project Number : N/A

Drawing Revision : B

Material : N/A

Due Date : 7/28/2007

Qty: 5 Um: Each

Written By :

Checked & Approved By :

Comment : Est: B 99.11.11 Re-format EC

OK TO PROCEED
UNTIL STEP 7.0
STOP AND SEE M.B.
07.06.22

Additional Product

Job Number:



Seq. #: Machine Or Operation:

Description :

1.0

DC

DOCUMENT CONTROL



Comment: DOCUMENT CONTROL

Photocopy bluefile & type labels per PPP D2003-041

2.0

M304TR0500W035

304 RD Tube .500 x .035W



Comment: Qty.: 0.5145 f(s)/Unit Total : 2.5725 f(s)

Material: 1/2" A x 0.035" wall AISI 304 SS tubing

Batch:

M104880 FF 07-07-04 5

3.0

M26506

Firesleeve-crkl .375IDia



Comment: Qty.: 0.5250 f(s)/Unit Total : 2.6250 f(s)

Material: M2650-6 Heat sleeve

Batch:

M103097

FF 07-07-04 5

4.0

MS208198J

Sleeve



Comment: Qty.: 2.0000 Each(s)/Unit Total : 10.0000 Each(s)

Pick:

Qty Part Number

Description

Batch

2 MS20819-8J

Sleeve

M103176 x4 / M103344 x6

FF 07-07-04 5

5.0

AN8188J

Nut



Comment: Qty.: 2.0000 Each(s)/Unit Total : 10.0000 Each(s)

Pick:

Qty Part Number

Description

Batch

2 AN818-8J Nut

M101189

FF 07-07-04 5

Dart Aerospace Ltd

W/O:		WORK ORDER CHANGES					
DATE	STEP	PROCEDURE CHANGE	By	Date	Qty	Approval Chief Eng / Prod Mgr	Approval QC Inspector

Part No: _____ PAR #: _____ Fault Category: _____ NCR: Yes ☒ No ☐ DQA: D Date: 07/02/09
 QA: N/C Closed: _____ Date: _____

NCR:		WORK ORDER NON-CONFORMANCE (NCR)						
DATE	STEP	Description of NC Section A	Corrective Action Section B			Verification Section C	Approval Chief Eng	Approval QC Inspector
			Initial Chief Eng	Action Description Chief Eng	Sign & Date			

NOTE: Date & initial all entries

Date: Thursday, 6/21/2007 2:27:02 PM
User: Kim Johnston

Process Sheet

Customer: CU-DAR001 Dart Helicopters Services

Drawing Name: TUBE ASSEMBLY

Job Number: 33030

Part Number: D2003041

Job Number:



Seq. #:

Machine Or Operation:

Description:

6.0

D2182

Heat Shrink



Comment: Qty.: 0.3750 f(s)/Unit Total: 1.8750 f(s)

Pick:

Qty Part Number Description

Batch

1 D2182-045 Heat shrink

B26009

FF 07-07-04

7.0

SMALL FAB 1

SMALL & MEDIUM FAB RESOURCE 1



Comment: SMALL & MEDIUM FAB RESOURCE 1

1-Cut: 5.88" long as per Dwg D2003

2-Cut: 6.00" long as per Dwg D2003

3-Form tube as per template D2003-041

4-Assemble as per Dwg D2003

SEE M.B:

FF 07-07-04

FF 07-07-30

8.0

QC5

INSPECT WORK TO CURRENT STEP



Comment: INSPECT WORK TO CURRENT STEP

Er 07/4/31 (45)

9.0

PACKAGING 1

PACKAGING RESOURCE #1



Comment: PACKAGING RESOURCE #1

Identify and Stock

Location: sts

Er 7/7/31 (5) 7/1/8 (5)

10.0

QC21

FINAL INSPECTION/W/O RELEASE



Comment: FINAL INSPECTION/W/O RELEASE

Er 7/10/08

Job Completion



Er 07-07-31

W/O:		WORK ORDER CHANGES					
DATE	STEP	PROCEDURE CHANGE	By	Date	Qty	Approval Chief Eng / Prod Mgr	Approval QC Inspector

Part No: _____ PAR #: _____ Fault Category: _____ NCR: Yes No DQA: _____ Date: _____

QA: N/C Closed: _____ Date: _____

NCR:		WORK ORDER NON-CONFORMANCE (NCR)						
DATE	STEP	Description of NC Section A	Corrective Action Section B			Verification Section C	Approval Chief Eng	Approval QC Inspector
			Initial Chief Eng	Action Description Chief Eng	Sign & Date			

NOTE: Date & initial all entries



DESIGN A	DRAWN BY SP	DART AEROSPACE LTD HAWKESBURY, ONTARIO, CANADA	
CHECKED JE	APPROVED A	DRAWING NO. D2003	REV. B SHEET 1 OF 2
DATE 99.06.08		TITLE 206 CABIN HEATER TUBE ASSEMBLIES NTS	SCALE
A	90.04.09	NEW ISSUE	
B	99.06.08	UPDATE PER TEMPLATES; ADD P/N'S; 0.025 TUBING NOW 0.035 (TSR1049)	

RELEASED
44-06-08 KE

~~UNDER REVIEW~~

06.08.21 CB

some flat
lengths wrong

4070622

P/N	TEMPLATE	HEATSLEEVE LENGTH ¹	CUT LENGTH OF TUBE ²	MS20819-8J SLEEVE	AN818-8J NUT	MS20819-8D SLEEVE	AN818-8D NUT	MS20819-6D SLEEVE	AN818-6D NUT	DESC.	MATERIAL ^{4/5/7}	VENDOR OR SPEC
D2003-001	T2003-001	5.2	6.00					2	2	TUBE ASS'Y	6061-T6 0.375 OD x 0.035 W	WWW-T-700/6
D2003-003	T2003-003	7.3	8.12					2	2	TUBE ASS'Y	6061-T6 0.375 OD x 0.035 W	WWW-T-700/6
D2003-005	T2003-005	9.8	10.62					2	2	TUBE ASS'Y	6061-T6 0.375 OD x 0.035 W	WWW-T-700/6
D2003-007	T2003-007	20.0	19.63					2	2	TUBE ASS'Y	6061-T6 0.375 OD x 0.035 W	WWW-T-700/6
D2003-009	T2003-009	12.38	12.44					2	2	TUBE ASS'Y	6061-T6 0.375 OD x 0.035 W	WWW-T-700/6
D2003-011	T2003-011	33.31	32.38					2	2	TUBE ASS'Y	6061-T6 0.375 OD x 0.035 W	WWW-T-700/6
D2003-013	T2003-013	12.7	13.54					2	2	TUBE ASS'Y	6061-T6 0.375 OD x 0.035 W	WWW-T-700/6
D2003-015	T2003-015	17.2	18.00					2	2	TUBE ASS'Y	6061-T6 0.375 OD x 0.035 W	WWW-T-700/6
D2003-017	T2003-017	17.0	16.25					2	2	TUBE ASS'Y	6061-T6 0.375 OD x 0.035 W	WWW-T-700/6
D2003-019	T2003-019	9.8	10.62			2	2			TUBE ASS'Y	6061-T6 0.500 OD x 0.035 W	WWW-T-700/6
D2003-021	T2003-021	N/A	2.25			2	2			TUBE ASS'Y	6061-T6 0.500 OD x 0.035 W	WWW-T-700/6
D2003-023	T2003-023	4.5	5.33			2	2			TUBE ASS'Y	6061-T6 0.500 OD x 0.035 W	WWW-T-700/6
D2003-025	T2003-025	9.8	10.60			2	2			TUBE ASS'Y	6061-T6 0.500 OD x 0.035 W	WWW-T-700/6
D2003-027	T2003-027	7.25	7.38			2	2			TUBE ASS'Y	6061-T6 0.500 OD x 0.035 W	WWW-T-700/6
D2003-029	T2003-029	17.2	18.00			2	2			TUBE ASS'Y	6061-T6 0.500 OD x 0.035 W	WWW-T-700/6
D2003-031	T2003-031	14.6	15.38	2	2					TUBE ASS'Y	CRES 0.500 OD x 0.035 W	AISI 304
D2003-033	T2003-033	29.75	29.62	2	2					TUBE ASS'Y	CRES 0.500 OD x 0.035 W	AISI 304
D2003-035	T2003-035	24.7	27.00	2	2					TUBE ASS'Y	CRES 0.500 OD x 0.035 W	AISI 304
D2003-037	T2003-037	24.81	23.38	2	2					TUBE ASS'Y	CRES 0.500 OD x 0.035 W	AISI 304
D2003-039	T2003-039	34.0	34.00	2	2					TUBE ASS'Y	CRES 0.500 OD x 0.035 W	AISI 304
D2003-041	T2003-041	6.0	5.88	2	2					TUBE ASS'Y	CRES 0.500 OD x 0.035 W	AISI 304
D2003-043	T2003-043	11.7	10.75	2	2					TUBE ASS'Y	CRES 0.500 OD x 0.035 W	AISI 304
D2003-045	T2003-045	3.50	2.44	2	2					TUBE ASS'Y	CRES 0.500 OD x 0.035 W	AISI 304
D2003-047	T2003-047	5.56	5.56	2	2					TUBE ASS'Y	CRES 0.500 OD x 0.035 W	AISI 304
D2003-049	T2003-049	33.2	34.00	2	2					TUBE ASS'Y	CRES 0.500 OD x 0.035 W	AISI 304
D2003-077	T2003-077	N/A	6.25					1	1	JET	6061-T6 0.375 OD x 0.035 W	WWW-T-700/6
D2003-101	T2003-101	13.25	13.13					2	2	TUBE ASS'Y	6061-T6 0.375 OD x 0.035 W	WWW-T-600/6
D2003-103	T2003-103	12.38	12.00					2	2	TUBE ASS'Y	6061-T6 0.375 OD x 0.035 W	WWW-T-600/6
D2003-105	T2003-105	10.75	10.60					2	2	TUBE ASS'Y	6061-T6 0.375 OD x 0.035 W	WWW-T-600/6
D2003-107	T2003-107	12.75	12.25					2	2	TUBE ASS'Y	6061-T6 0.375 OD x 0.035 W	WWW-T-600/6
D2003-109	T2003-109	8.25	8.125			2	2			TUBE ASS'Y	6061-T6 0.500 OD x 0.035 W	WWW-T-600/6
D2003-111	T2003-111	4.75	4.625			2	2			TUBE ASS'Y	6061-T6 0.500 OD x 0.035 W	WWW-T-600/6
D2003-116	T2003-116	4.0								HEATSLEEVE	M2650-20 CRINKLE-SOFT	STRATOFLEX
D2003-120	T2003-120	4.0								HEATSLEEVE	M2650-16 CRINKLE-SOFT	STRATOFLEX
D2003-14	T2003-14	4.0								HEATSLEEVE	M2650-14 CRINKLE-SOFT	STRATOFLEX
D2003-16	T2003-16	4.0								HEATSLEEVE	M2650-16 CRINKLE-SOFT	STRATOFLEX
D2003-205	T2003-205	9.75	9.60					2	2	TUBE ASS'Y	6061-T6 0.375 OD x 0.035 W	WWW-T-700/6
D2003-207	T2003-207	3.75	3.75					2	2	TUBE ASS'Y	6061-T6 0.375 OD x 0.035 W	WWW-T-700/6

OK

UNCONTROLLED COPY
SUBJECT TO AMENDMENT
WITHOUT NOTICE

~~WORK ORDER~~
~~WORK ORDER~~

NO. 33030



DESIGN <i>[Signature]</i>	DRAWN BY <i>[Signature]</i>	DART AEROSPACE LTD HAWKESBURY, ONTARIO, CANADA	
CHECKED <i>[Signature]</i>	APPROVED <i>[Signature]</i>	DRAWING NO. D2003	REV. B SHEET 2 OF 2
DATE 99.06.08		TITLE 206 CABIN HEATER TUBE ASSEMBLIES NTS	

RELEASED
99.06.08 KE

UNDER REVIEW


06.08.1 CB

Some Flat lengths
wrong

07.06.22

Notes:

- (1) USE STRATOFLEX M2650-6 CRINKLE-SOFT HEATSLEEVE.
- (2) TUBING ASSEMBLIES TO BE CUT AND BENT IN ACCORDANCE WITH TEMPLATES.
- (3) TUBES TO BE FLARED 30° TO MATE WITH FITTINGS MADE TO MS33514.
- (4) ENSURE SEAMLESS TUBING IS USED.
- (5) INSTALL HEATSLEEVE OVER ALL TUBES WITH A DESIGNATED LENGTH OF HEATSLEEVE PER THE PARTS LIST.
- (6) 5052 (WW-T-700/4) TUBING MAY BE SUBSTITUTED WHEN 6061 TUBING IS NOT AVAILABLE.
- (7) 0.049 WALL THICKNESS CRES TUBING MAY BE SUBSTITUTED WHEN 0.035 IS NOT AVAILABLE.
- (8) TOLERANCES ARE PER DART QSI 018 UNLESS OTHERWISE NOTED.

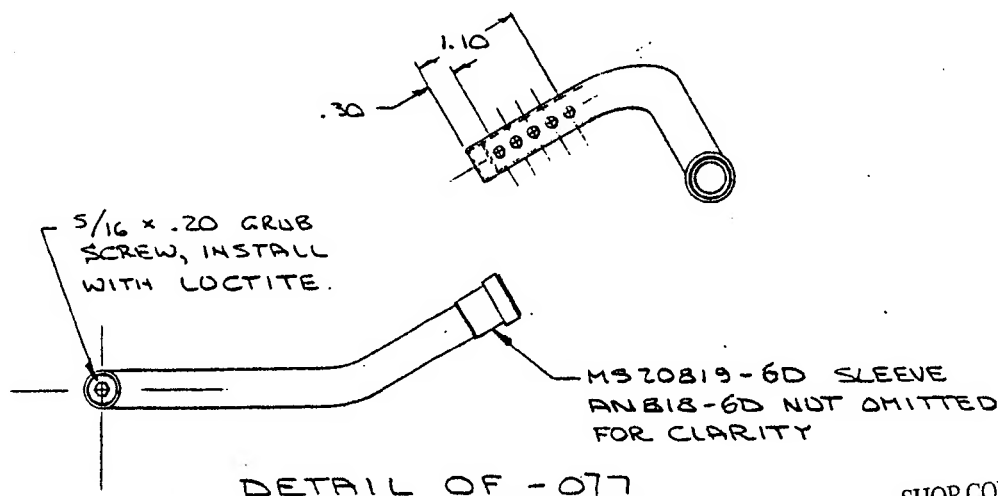

SHOP COPY
RETURN TO
ENGINEERING
UNCONTROLLED COPY
SUBJECT TO AMENDMENT
WITHOUT NOTICE
WORK ORDER
NO. 33030